


CERTIFICATION OF AS-BUILT ELEVATIONS

SURVEYORS STAMP

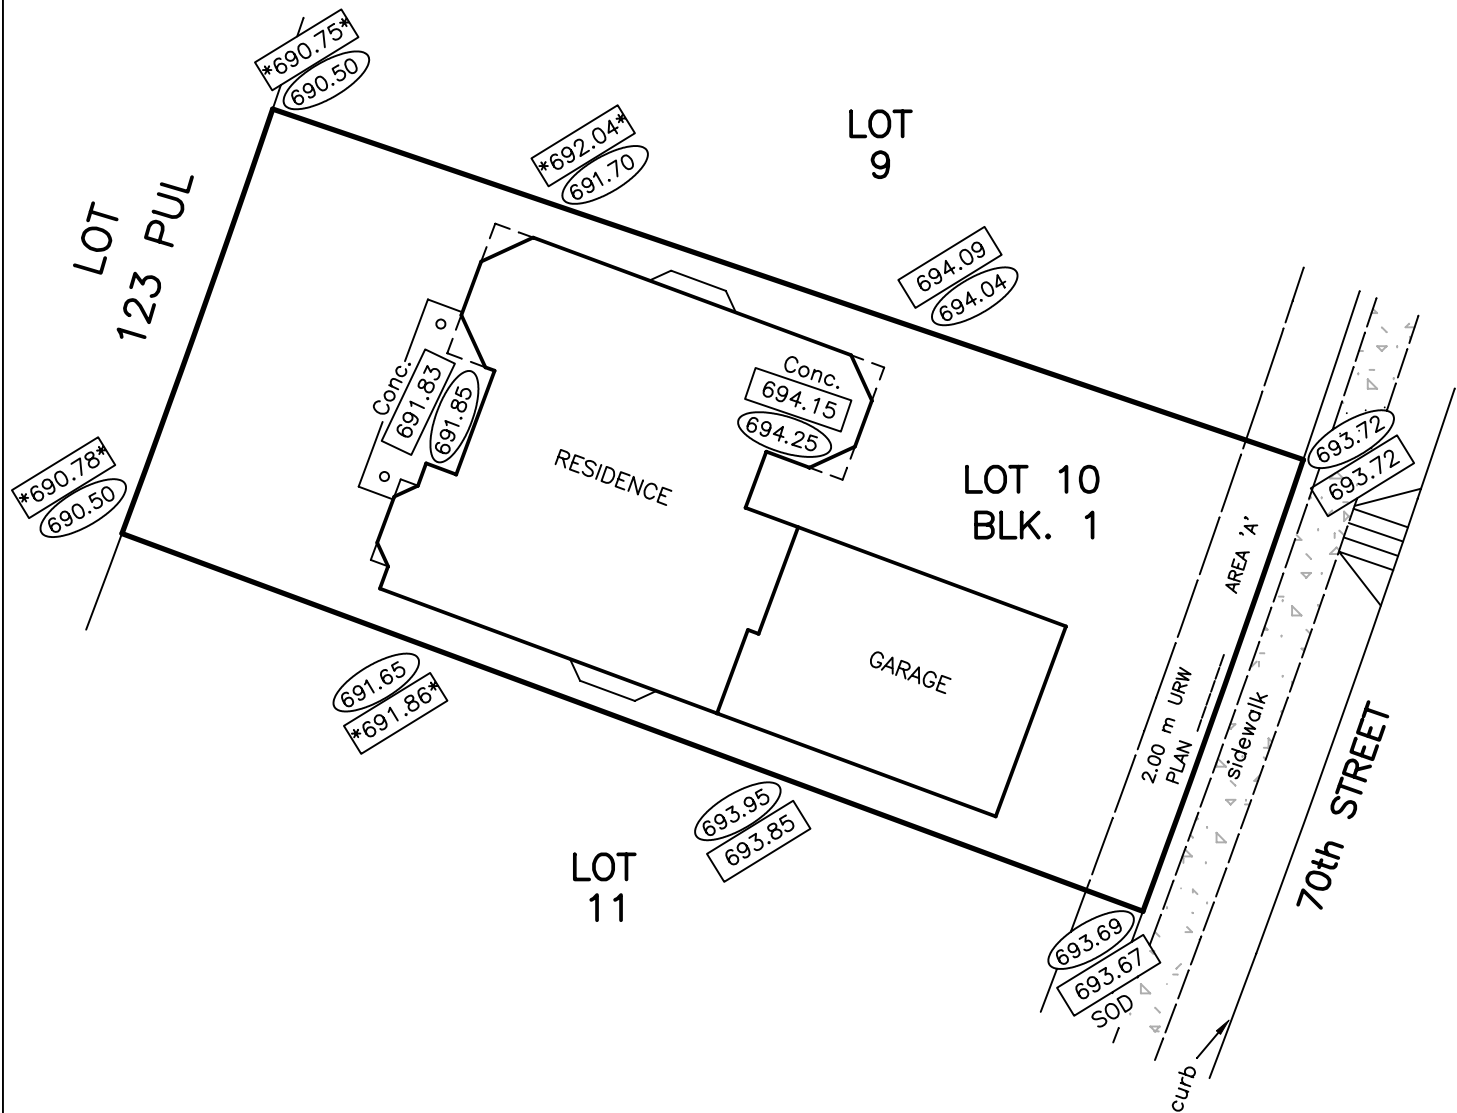

LOT	BLK.	PLAN	SUBDIVISION	BUILDER OR OWNER	DRAWN
-	-	-	-	-	-

SCALE: 1: 250	JOB NO. -	DATE: JUNE 15, 2009	ADDRESS -
---------------	-----------	---------------------	-----------

CONTACT INFORMATION:

NOTES:

ELEVATIONS SHOWN THUS *33.33* DO NOT CONFORM WITH THE LOT GRADING PLAN.


ELEVATIONS SHOWN ON THE ABOVE PLAN ARE BASED ON GEODETIC ELEVATIONS AND ARE TAKEN ON TOPSOIL, UNLESS OTHERWISE SHOWN.

ALL ELEVATIONS ARE IN METRES AND DECIMALS THEREOF.

PROPOSED ELEVATION



EXISTING ELEVATION

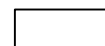

DATE: JUNE 18, 2009

THIS PLAN IS SUBJECT TO APPROVAL OF LOCAL APPROVING AUTHORITY.

ALBERTA LAND SURVEYOR